



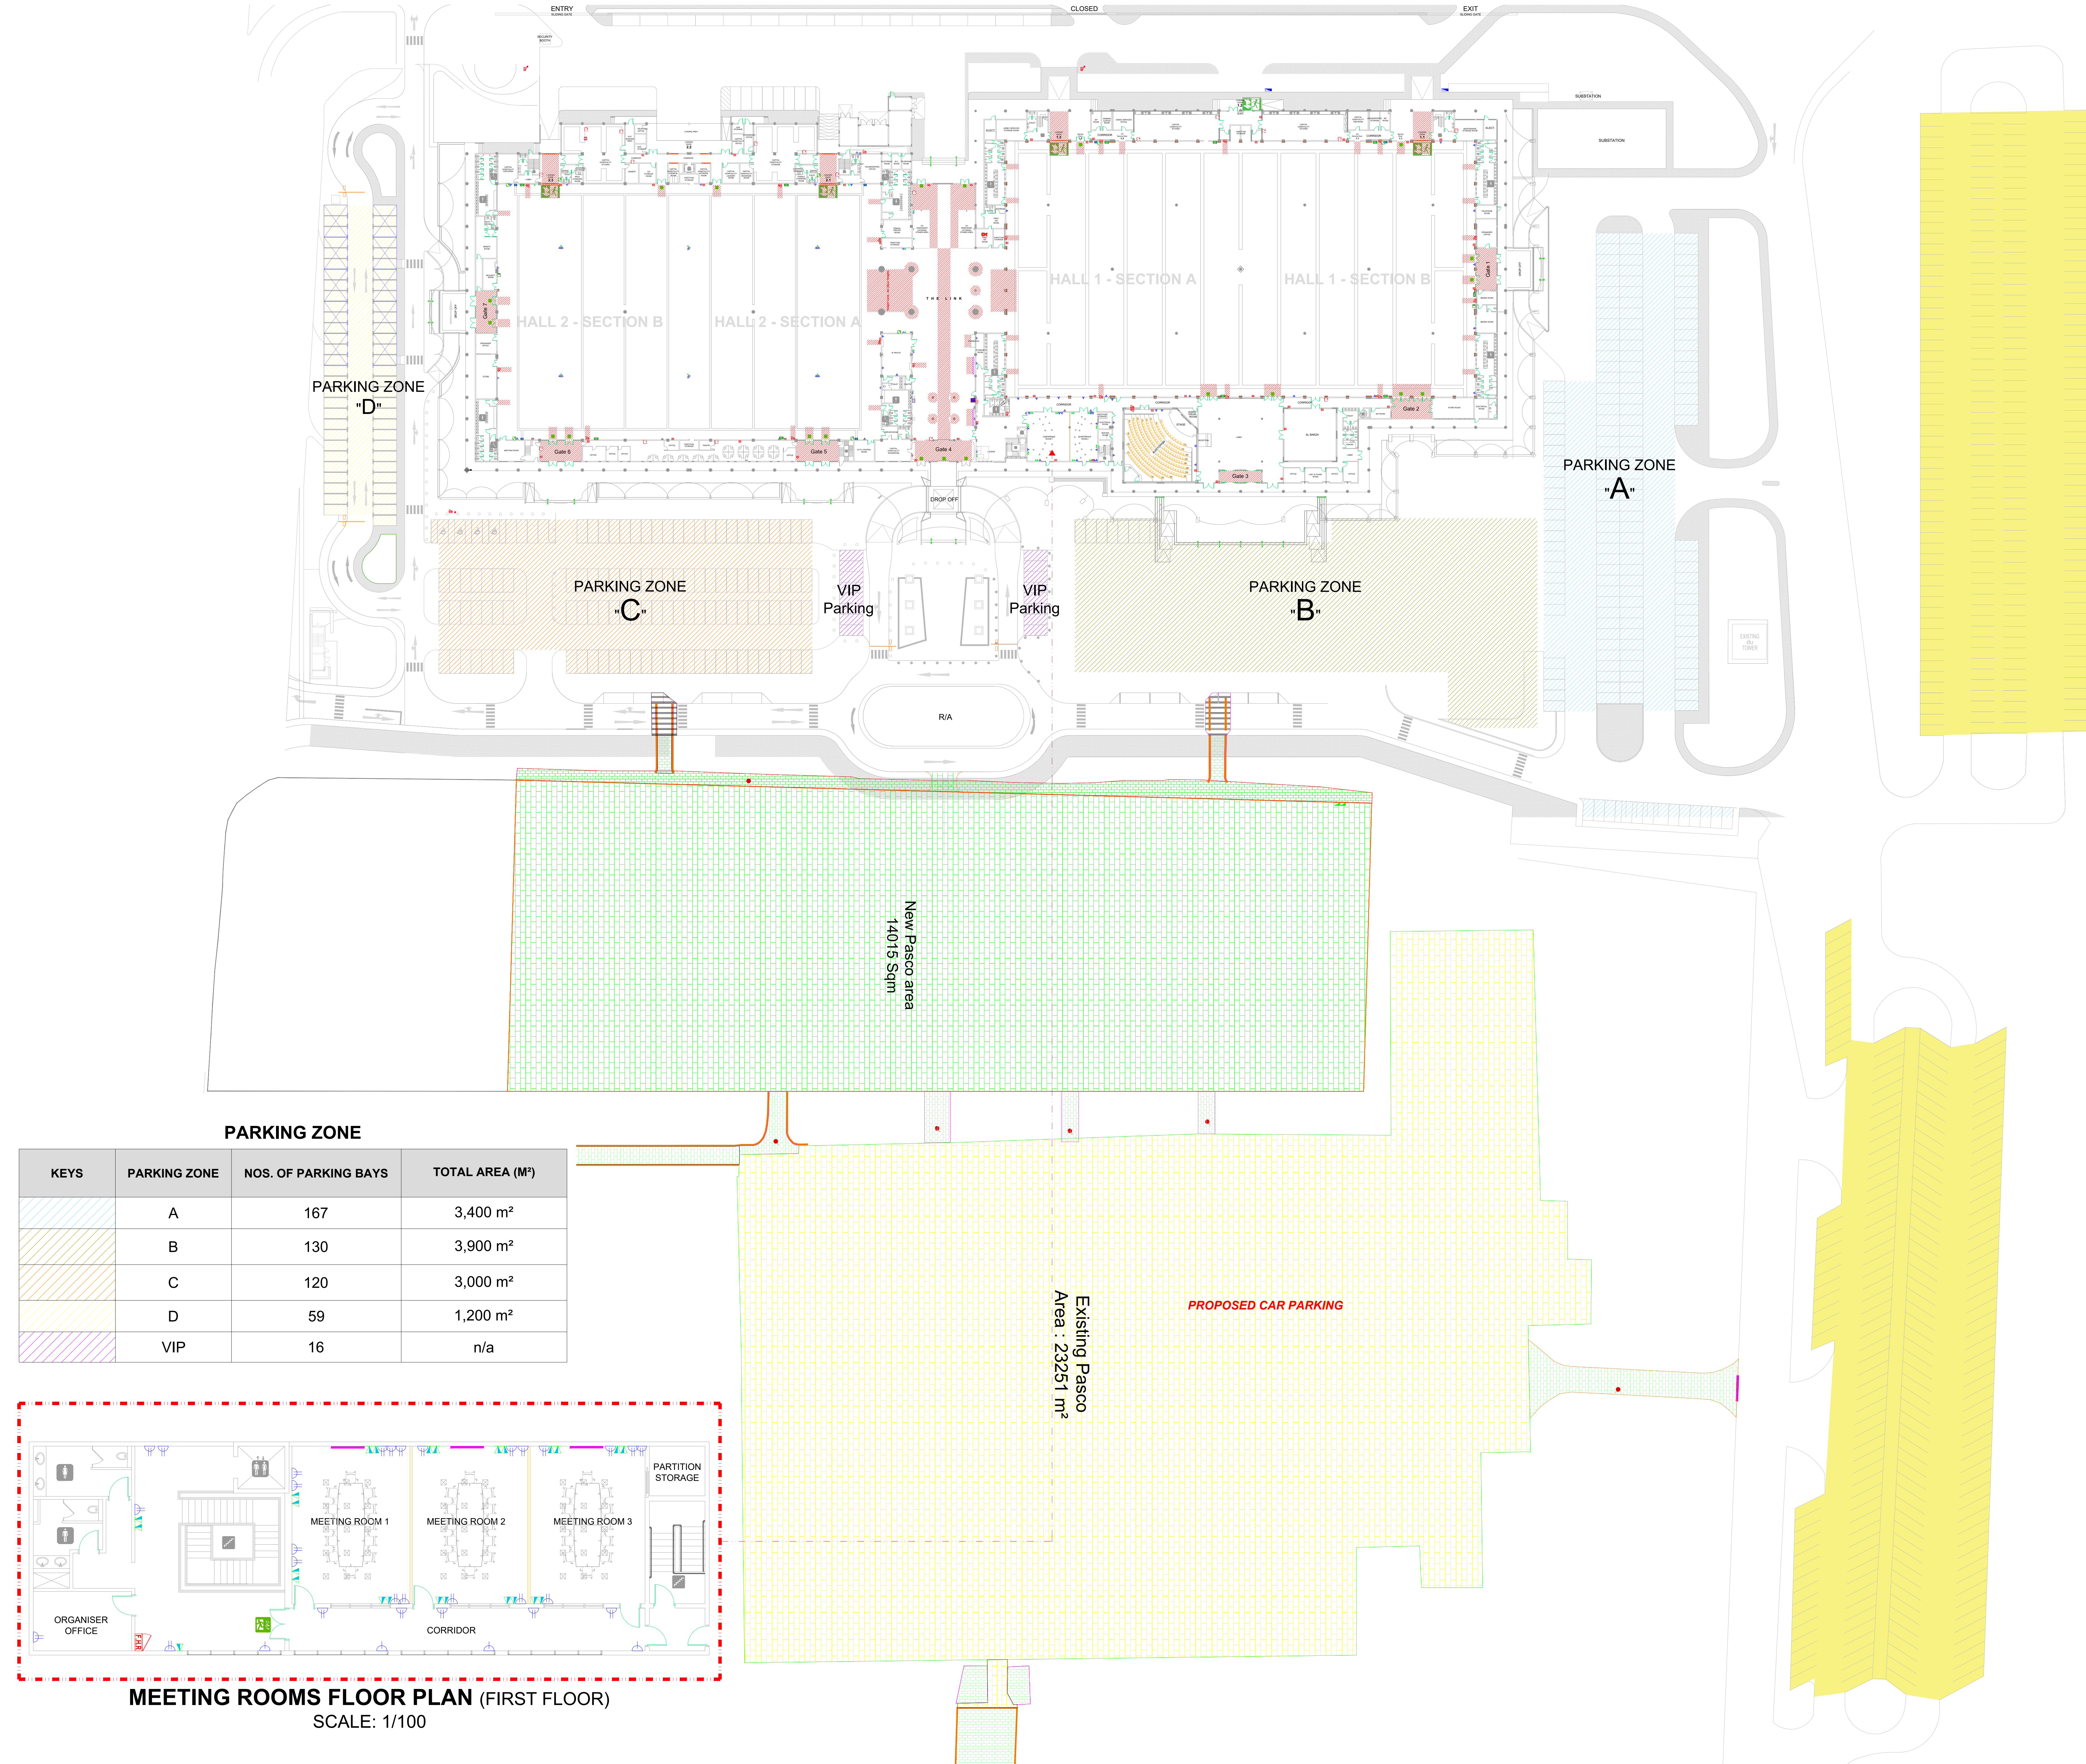

PARKING ZONE			
KEYS	PARKING ZONE	NOS. OF PARKING BAYS	TOTAL AREA (M²)
	A	167	3,400 m²
	B	130	3,900 m²
	C	120	3,000 m²
	D	59	1,200 m²
	VIP	16	n/a

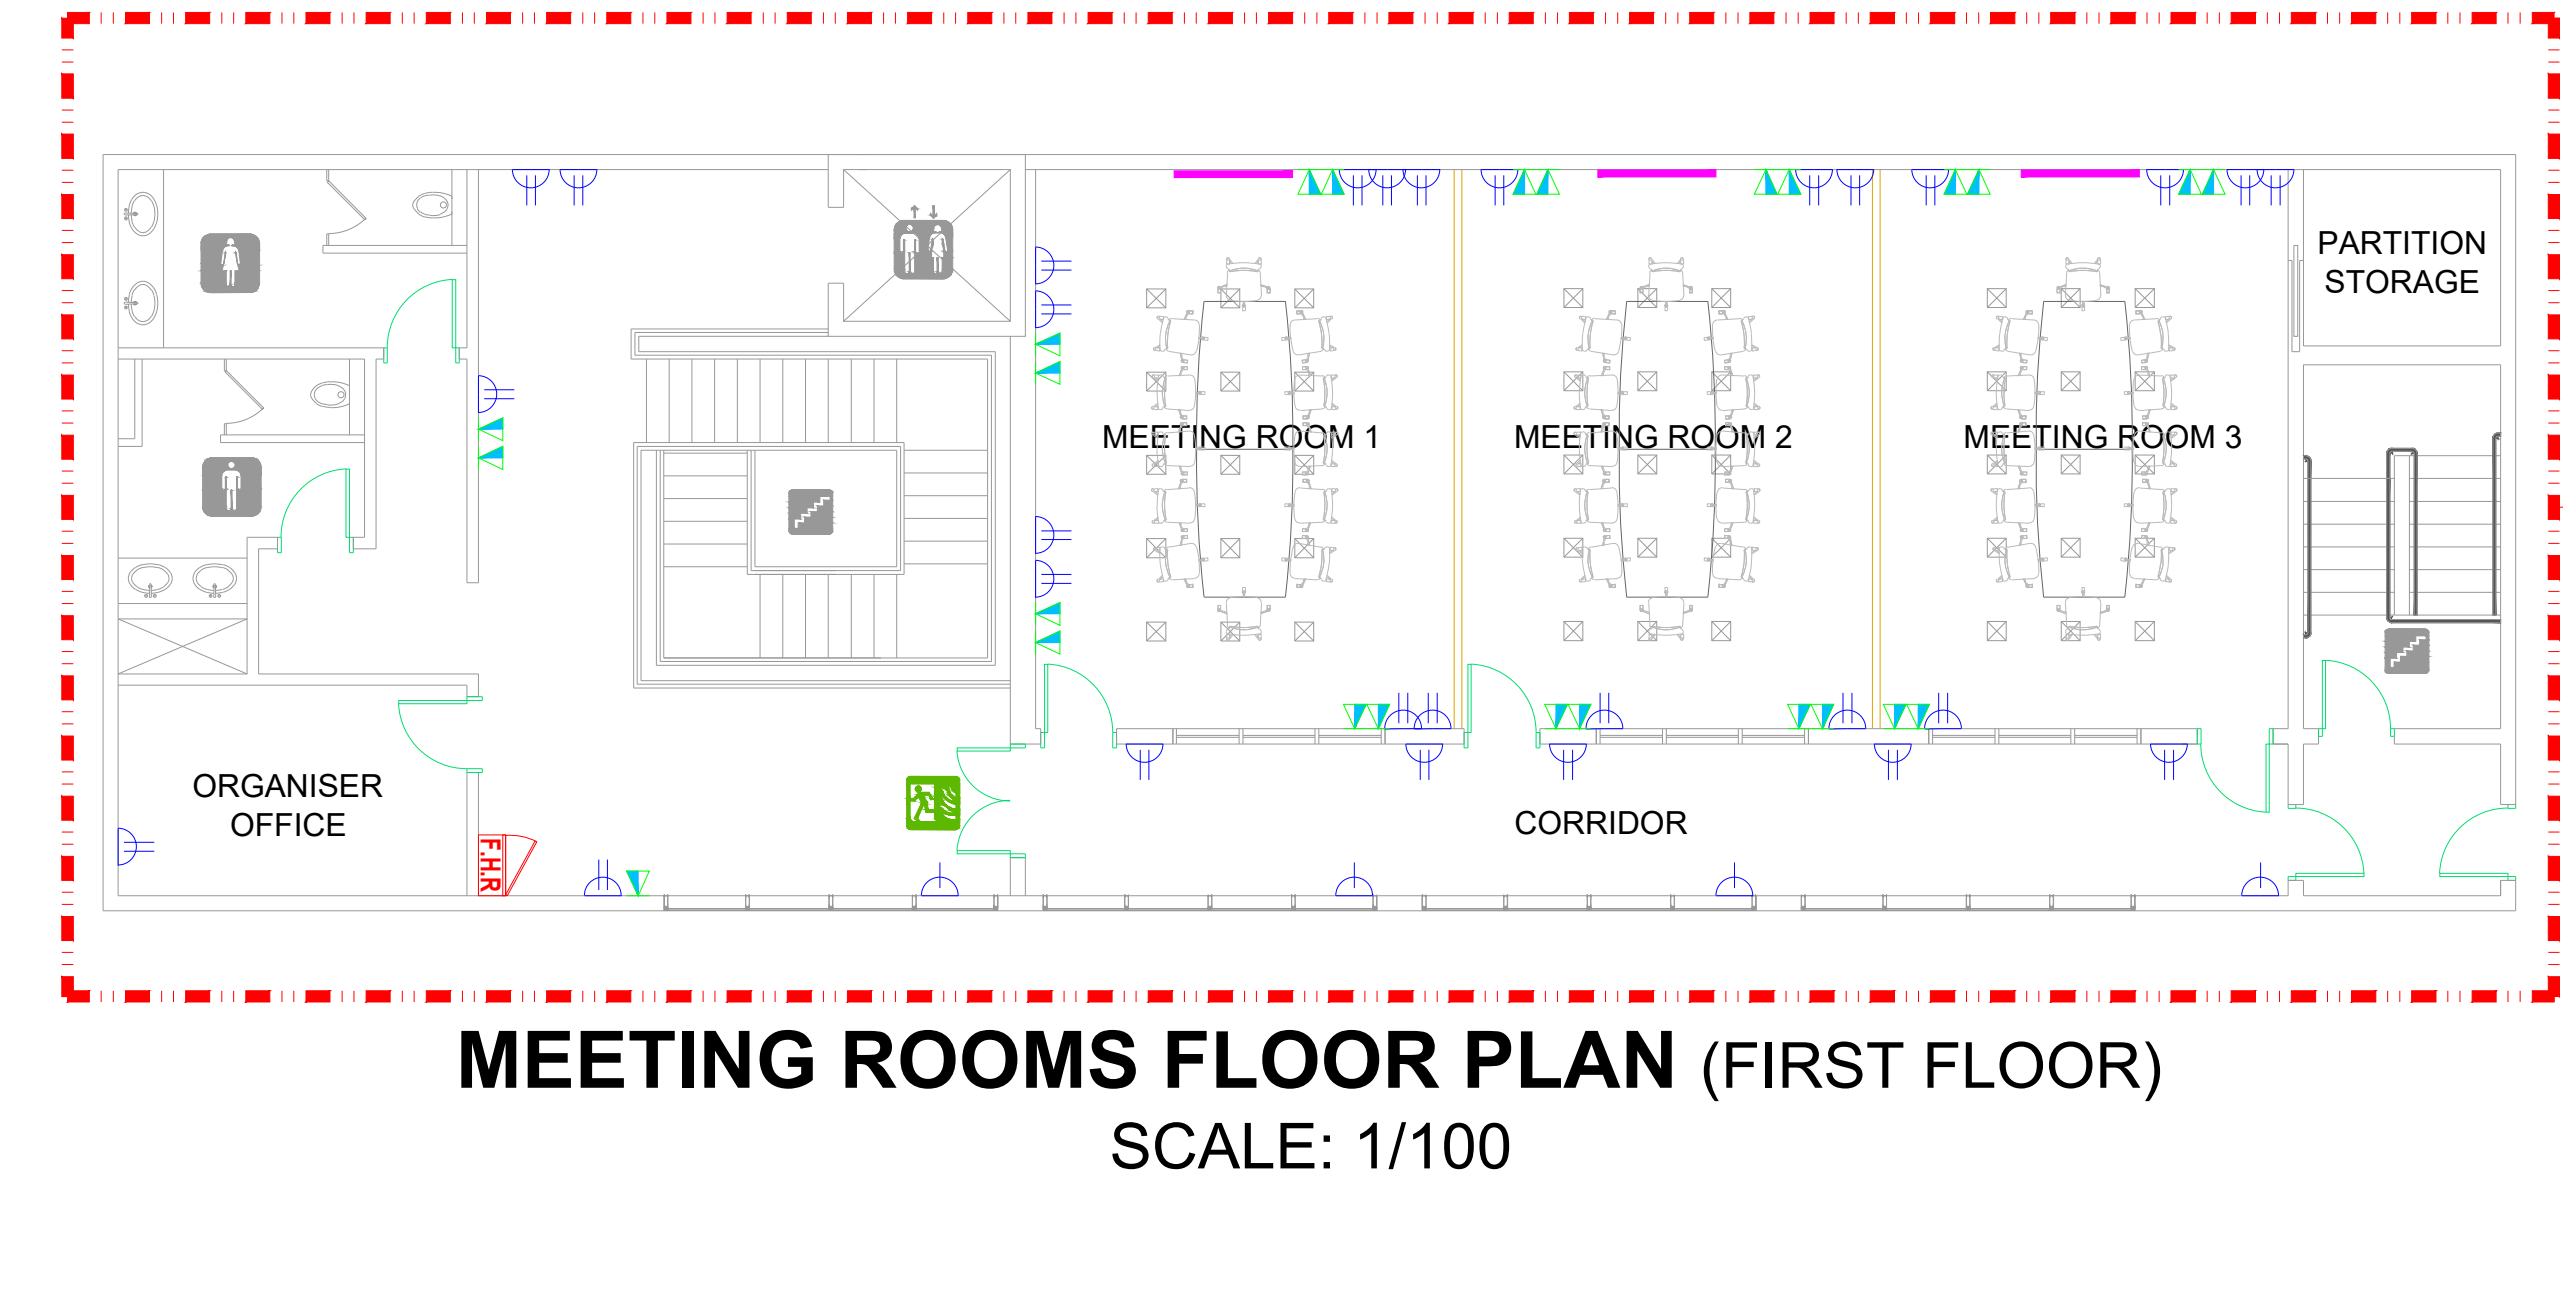

REV. #	REVISION	DATE	REVISED BY
4	- External Landscape & Parking has been added, numbering of all loading doors & adding NO BUILD Zone Hatch	6/3/2015	Chris
5	As per site Survey - Health & Safety Boxes, Sliding Gates, New partition wall @ Hall 1, Speaker location @ auditorium @ TCP boxes	17/11/2016	Chris
6	New meeting & conference rooms added including the additional car parking areas	12/03/2017	Chris
7	Update the outdoor venue	05/02/2025	Jun

LEGEND:

- Staircase
- Male Toilet
- Female Toilet
- Toilet for Disabled
- Kitchen
- Fire Hydrant
- Exit Door
- Medical Room
- Telephone Unit (Wall Mounted)
- Double Socket
- Data & Voice Port
- Voice Only
- TV Junction Box
- Single Socket
- Primary Hall Divider
- Hall Entrance Door
- Floor Trenches
- Loading door
- Water & Waste Floor Pit
- External Fire Hydrant
- External Distribution Board
- EHSMS No Build Zone
- Retail Area
- Under construction area
- Tent
- Health & Safety Boxes (First Aid Kit)
- TCP Boxes
- ATM Machine

© COPYRIGHT NOTICE

This drawing is provided in electronic format (.dwg file) for "information purposes" only without any liability on the part of ADNEC. The file, and its contents, remain the property of ADNEC, and shall not be reproduced or re-issued to any third party without express written authorisation from ADNEC. The drawing is for reference only and may be subject to change without notice. Updates to this drawing may occur at undefined intervals and shall be notified at the sole discretion of ADNEC. Users are responsible for ensuring that critical dimensions and features are independently verified prior to commencement of any works

DRAWING TITLE:	
AS BUILT - GROUND FLOOR GENERAL ARRANGEMENT	
SCALE:	1:500@A0
DATE:	05 January 2025
APPROVED BY:	TBC
DRAWN BY:	Jun